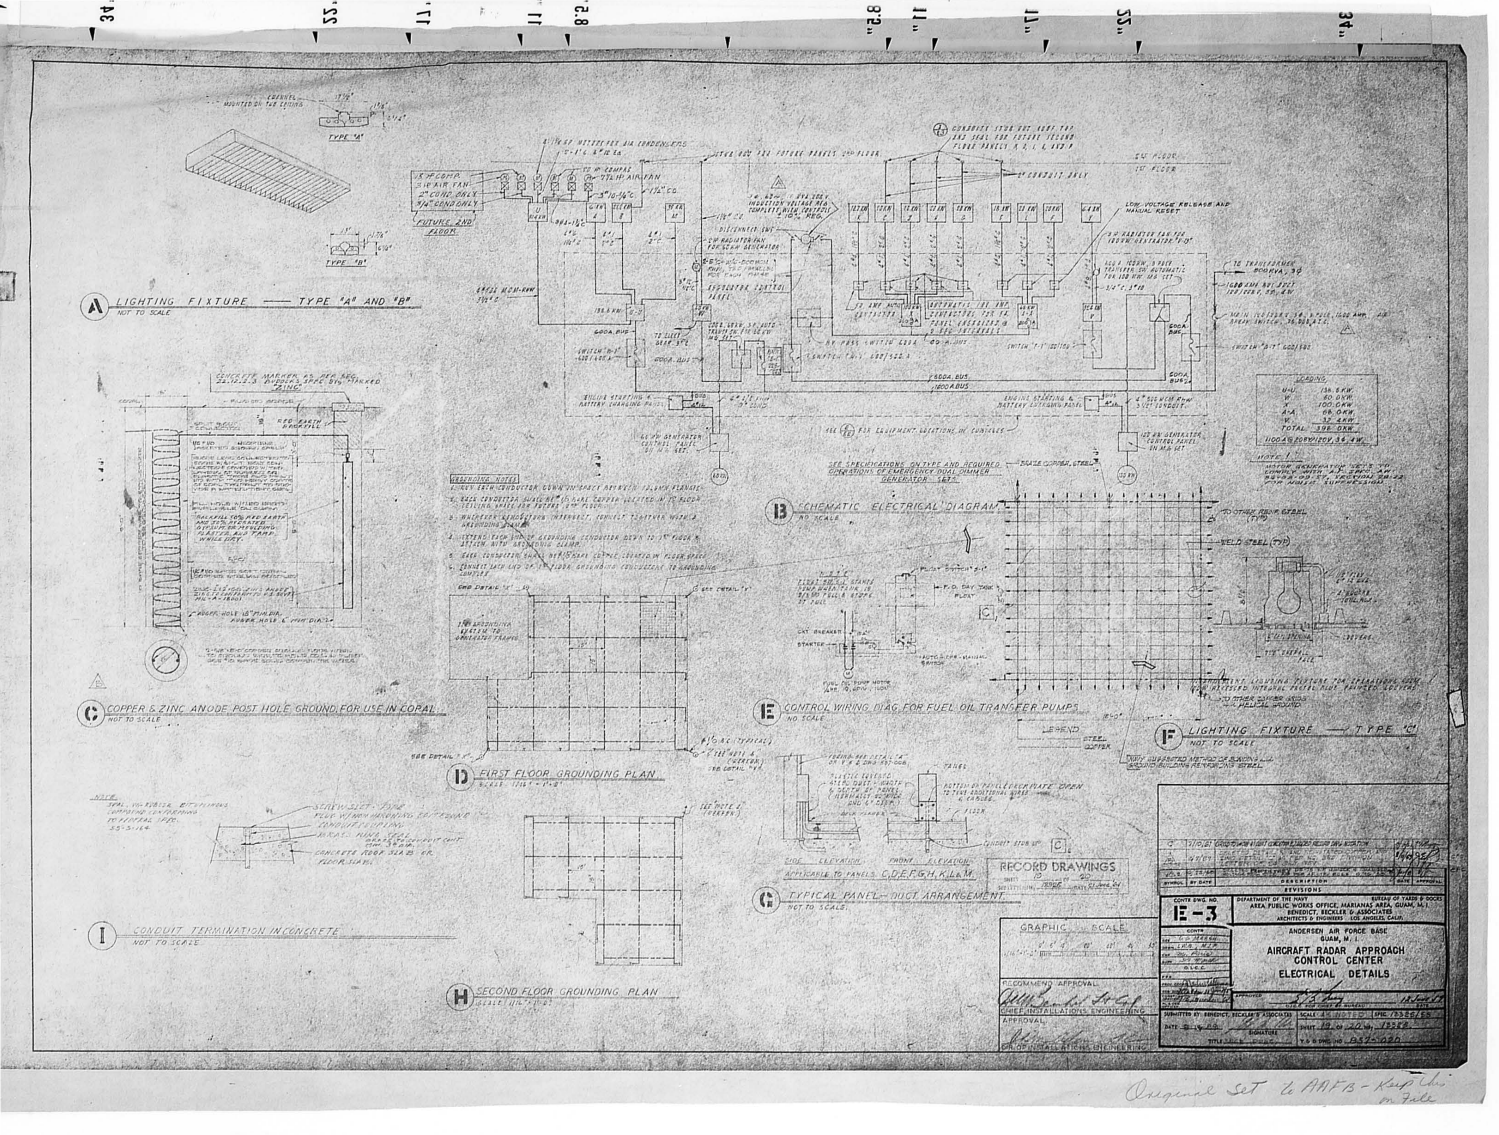
A LIGHTING FIXTURE — TYPE "A" AND "B"
NOT TO SCALE
B SCHEMATIC ELECTRICAL DIAGRAM
NO SCALE
C COPPER & ZINC ANODE POST HOLE GROUND FOR USE IN CORAL
NOT TO SCALE
D FIRST FLOOR GROUNDING PLAN
SCALE: 1/16" = 1'-0"
E CONTROL WIRING DIAG FOR FUEL OIL TRANSFER PUMPS
NO SCALE
F LIGHTING FIXTURE — TYPE "C"
NOT TO SCALE
G TYPICAL PANEL — DUCT ARRANGEMENT
NOT TO SCALE
H SECOND FLOOR GROUNDING PLAN
SCALE: 1/16" = 1'-0"
I CONDUIT TERMINATION IN CONCRETE
NOT TO SCALE
RECORD DRAWINGS
GRAPHIC SCALE
E-3
AIRCRAFT RADAR APPROACH CONTROL CENTER
ELECTRICAL DETAILS
ANDERSEN AIR FORCE BASE
GUAM, M. I.
DEPARTMENT OF THE NAVY
BUREAU OF YARDS & DOCKS
AREA PUBLIC WORKS OFFICE, MARIANAS AREA, GUAM, M.I.
BENEDICT, BECKLER & ASSOCIATES
ARCHITECTS & ENGINEERS LOS ANGELES, CALIF.
SUBMITTED BY: BENEDICT, BECKLER & ASSOCIATES
SCALE: AS NOTED
DATE: 12-20-50
DRAWING NO. 1525-480
RECOMMEND APPROVAL
CHIEF, INSTALLATIONS ENGINEERING
APPROVAL
CHIEF, PLANS & SPECIFICATIONS ENGINEERING
REVISIONS
SYMBOL | BY | DATE | DESCRIPTION | APPROVED
Original Set to AAFB - Keep this in File